



AERIAL PLAN
SCALE - NOT TO SCALE

DRAWING INDEX		
ARCHITECTURAL DRAWINGS		
DWG #	Revision #	DRAWING TITLE
A.00		COVER SHEET
A.100		SURVEY PLAN
A.101		EXISTING GROUND FLOOR PLAN
A.102		ELEVATIONS
A.103		ELEVATIONS CONT. & SHORT SECTION
A.104		SECTIONS



LOCATION PLAN
SCALE - NOT TO SCALE



ISSUE / REVISION

No.	Date:

SCALE: AS NOTED

SURVEY

Prepared By: _____ Date: _____

DESIGN

Prepared By: _____ Date: _____

Checked By: _____ Date: _____

DRAWING

Prepared By: *TC* Date: *FEBRUARY 2020*

Checked By: _____ Date: _____

Approved By: _____

Project Number:
00.00.00

Project Title:
DEVONSHIRE AGRICULTURE SERVICE CENTER

*#38 SCHOOLS DRIVE,
DEVONSHIRE.*

Sheet Title:
SURVEY

Revisions: _____ Sheet Number: _____

 **A.00**

ISSUED FOR INFORMATION

DEVONSHIRE AGRICULTURE SERVICE CENTER

#38 SCHOOLS DRIVE, DEVONSHIRE, MA 02


Prepared by

MINISTRY OF PUBLIC WORKS
ARCHITECTS & DESIGN SECTION

FOR

MINISTRY OF PUBLIC WORKS
ESTATES



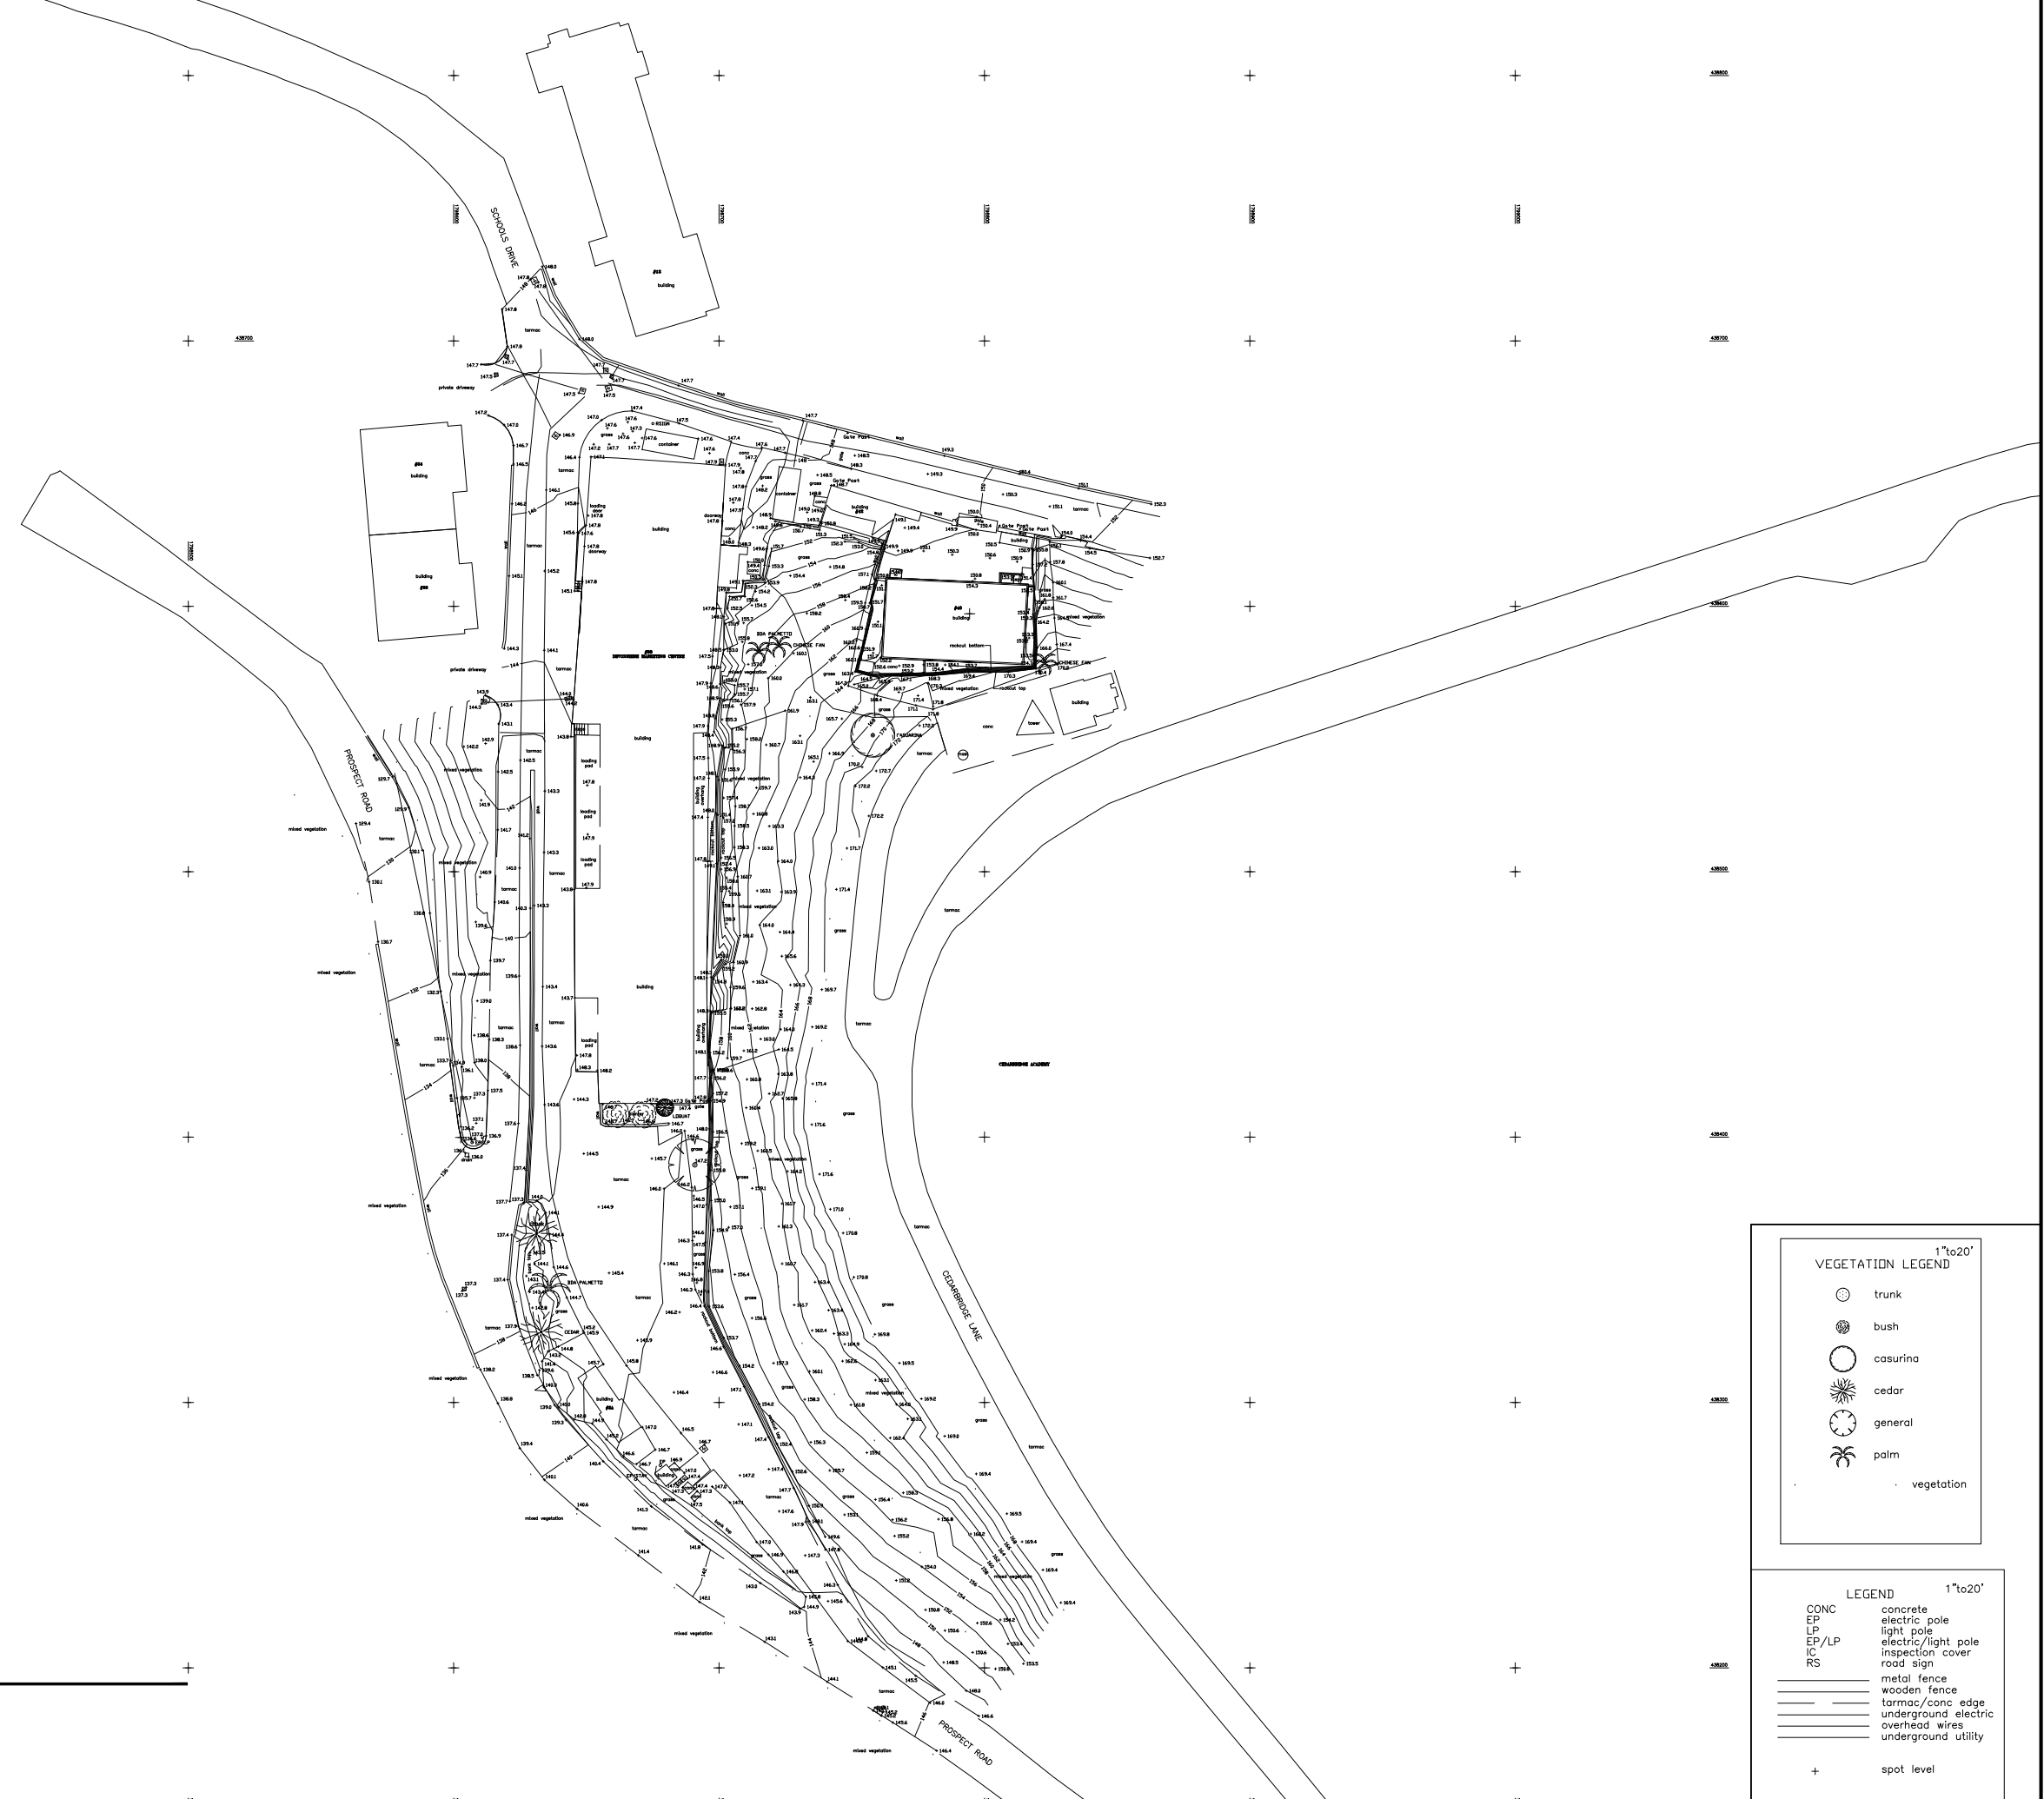

ISSUE / REVISION	
No.	Date:

SCALE: AS NOTED

SURVEY
Prepared By: _____ Date: _____

DESIGN
Prepared By: _____ Date: _____

Checked By: _____ Date: _____

DRAWING
Prepared By: *TC* Date: *FEBRUARY 2020*
Checked By: _____ Date: _____

Approved By: _____

Project Number:
00.00.00

Project Title:
**DEVONSHIRE AGRICULTURE
SERVICE CENTER**

*#38 SCHOOLS DRIVE,
DEVONSHIRE.*

Sheet Title:
SURVEY

Revisions: _____ Sheet Number: **A.100**

1 SURVEY
A.100 SCALE 1/32" = 1'-0"

VEGETATION LEGEND 1"=20'	
	trunk
	bush
	casurina
	cedar
	general
	palm
	vegetation


LEGEND 1"=20'	
CONC	concrete
EP	electric pole
LP	light pole
EP/LP	electric/light pole
IC	inspection cover
RS	road sign
	metal fence
	wooden fence
	tarmac/conc. edge
	underground electric
	overhead wires
	underground utility
+	spot level




Drawing legend

EXISTING WALL

EXISTING FILLED WALL

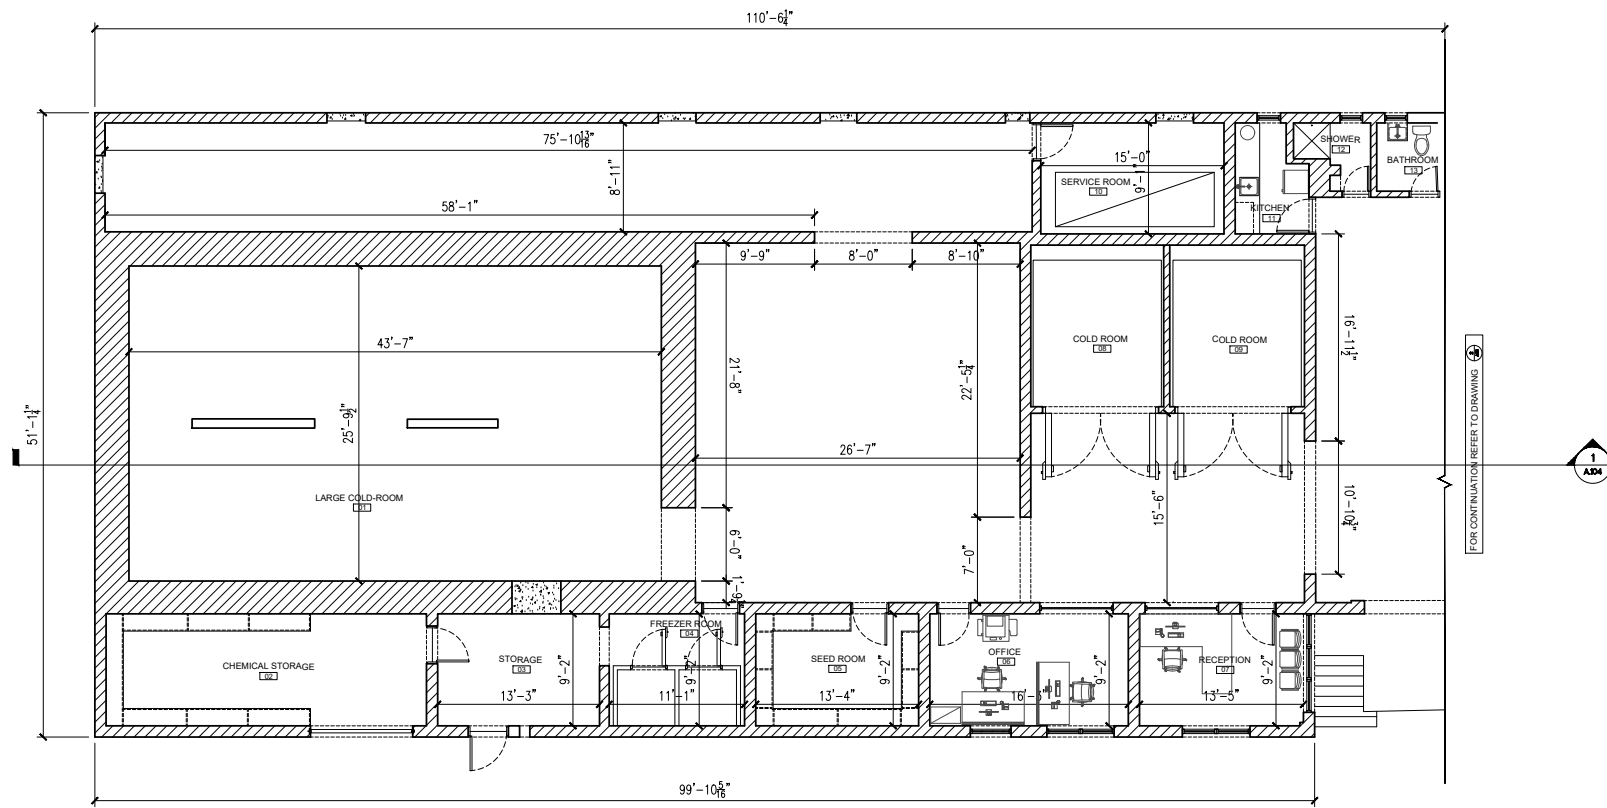

1 EXISTING GROUND FLOOR PLAN
A.101 SCALE: 1/8" = 1'-0"

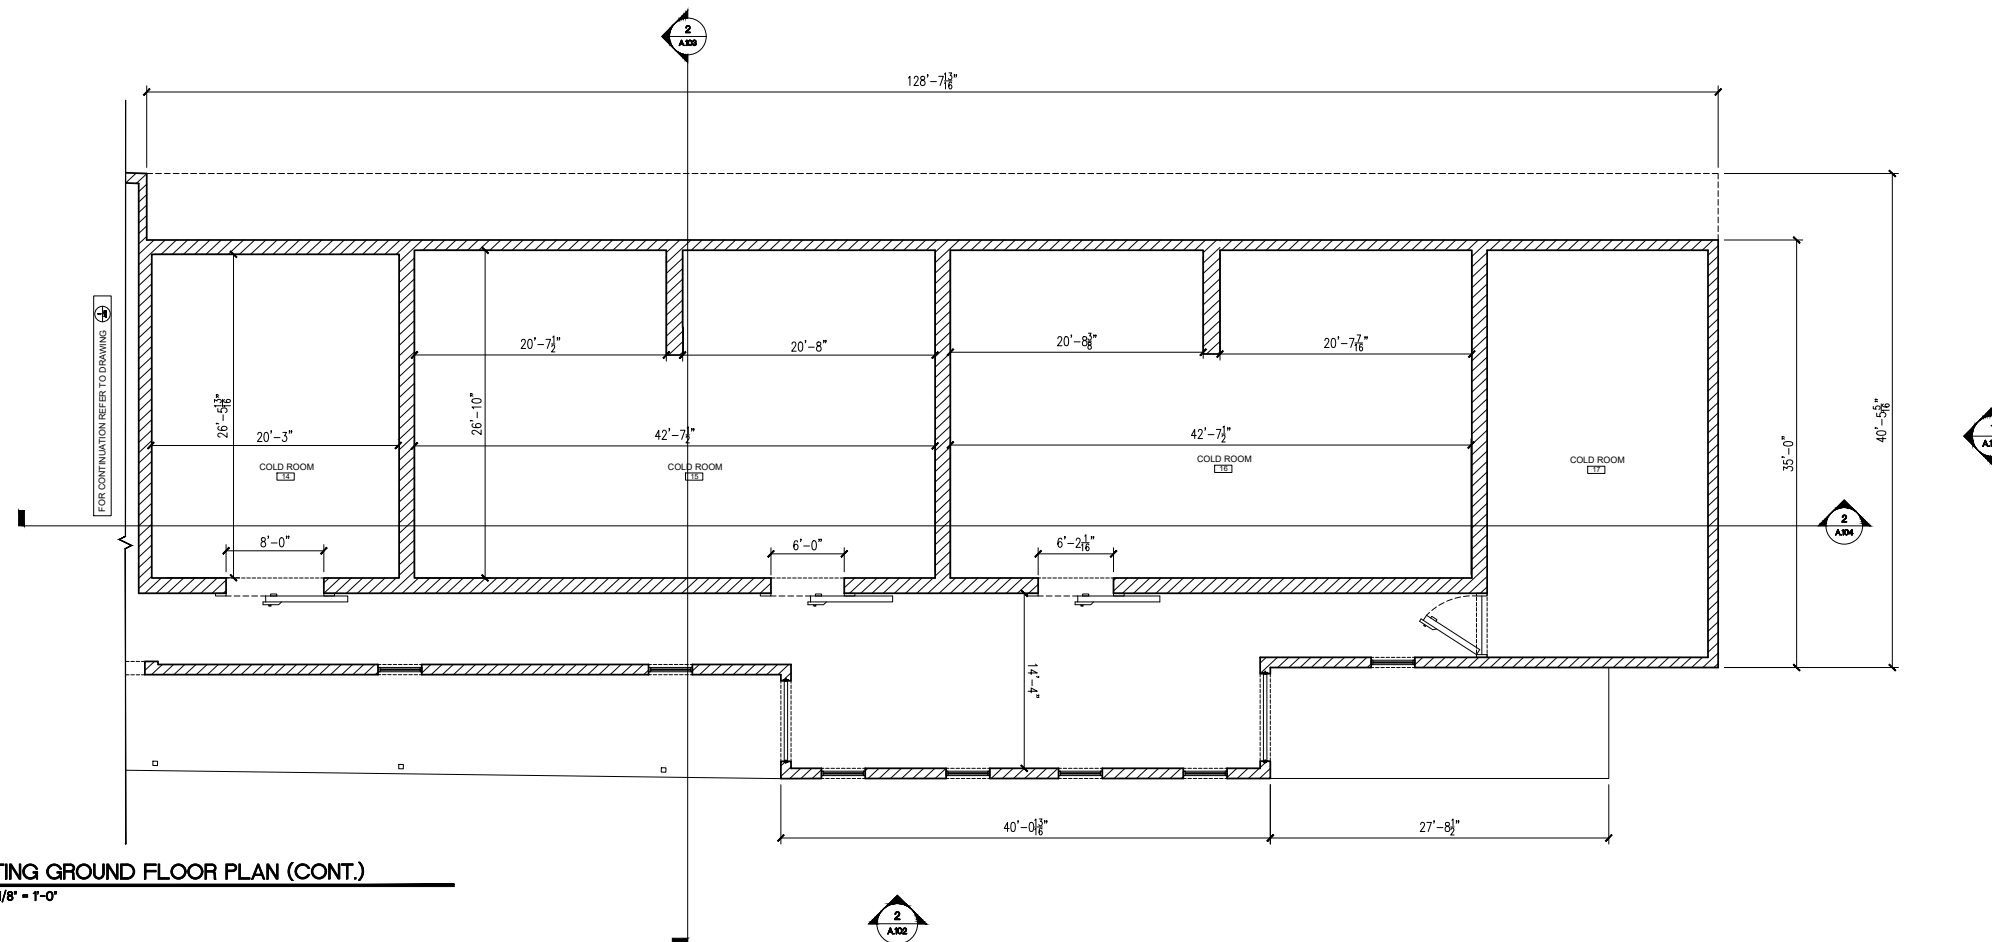

2 EXISTING GROUND FLOOR PLAN (CONT.)
A.101 SCALE: 1/8" = 1'-0"

ISSUE / REVISION

No.	Date:

SCALE: AS NOTED

SURVEY

Prepared By: OTHERS Date: -

DESIGN

Prepared By: - Date: -

Checked By: - Date: -

DRAWING

Prepared By: TC Date: FEBRUARY 2020

Checked By: - Date: -

Approved By: -

Project Number: 00.00.00


Project Title:
DEVONSHIRE AGRICULTURE
SERVICE CENTER

#38 SCHOOLS DRIVE,
DEVONSHIRE.


Sheet Title:
EXISTING GROUND FLOOR PLAN

Revisions: Sheet Number:


A.101

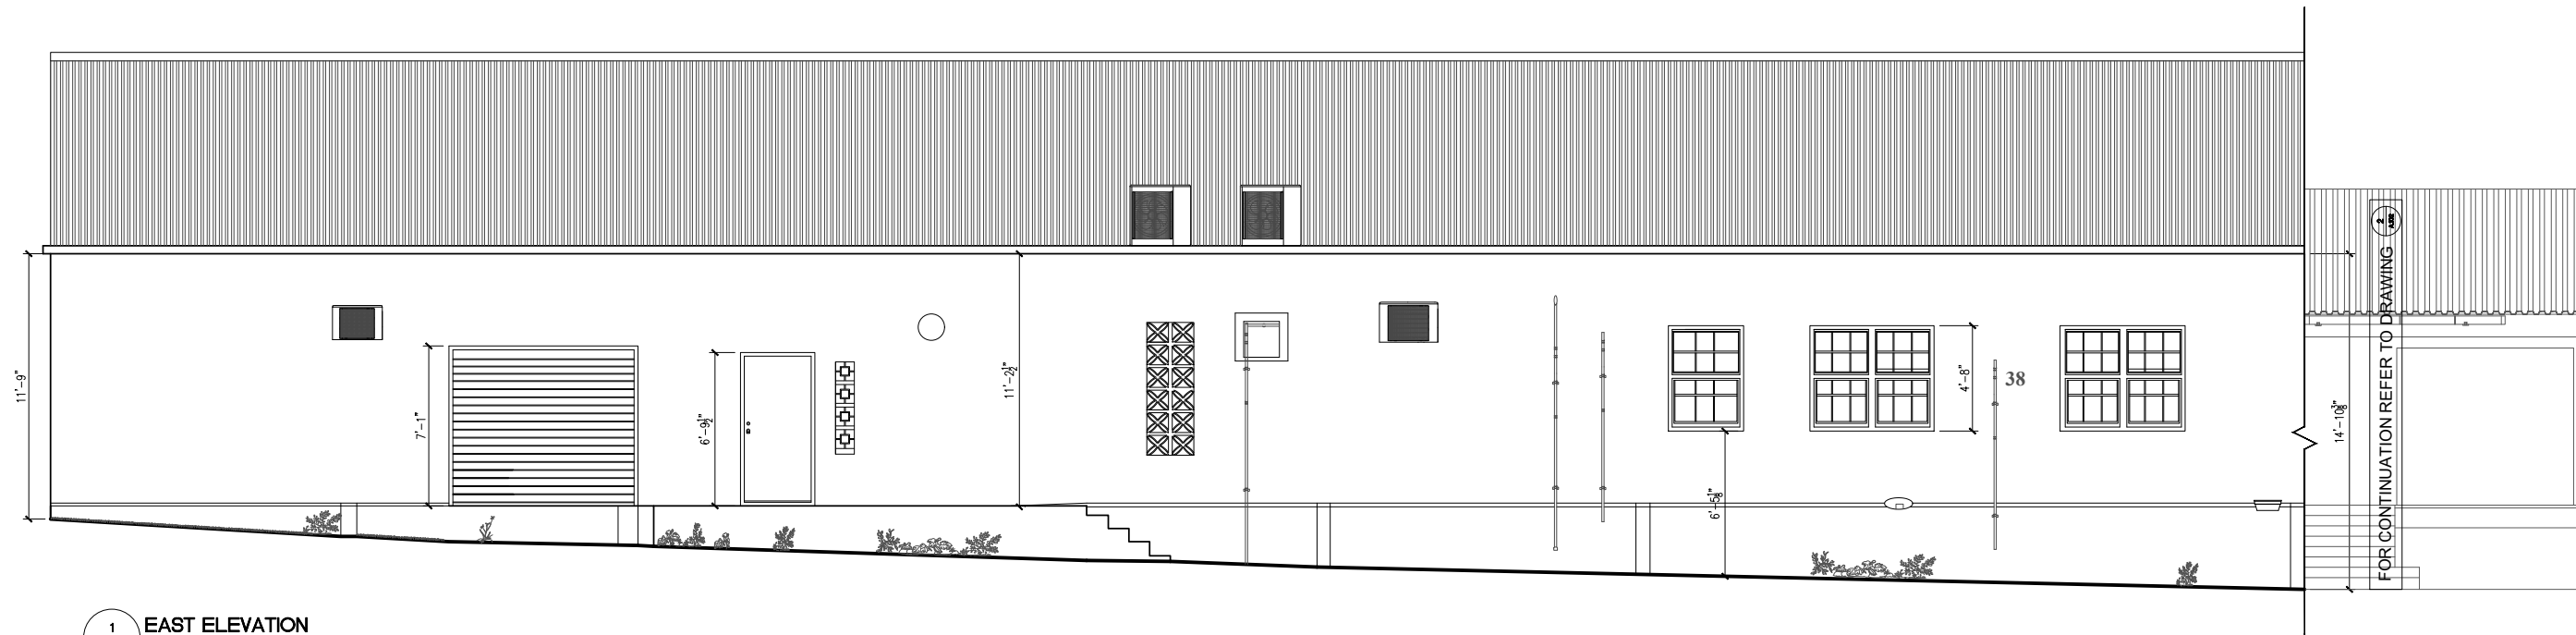


1 EAST ELEVATION
A.102 / SCALE 1/4" = 1'-0"

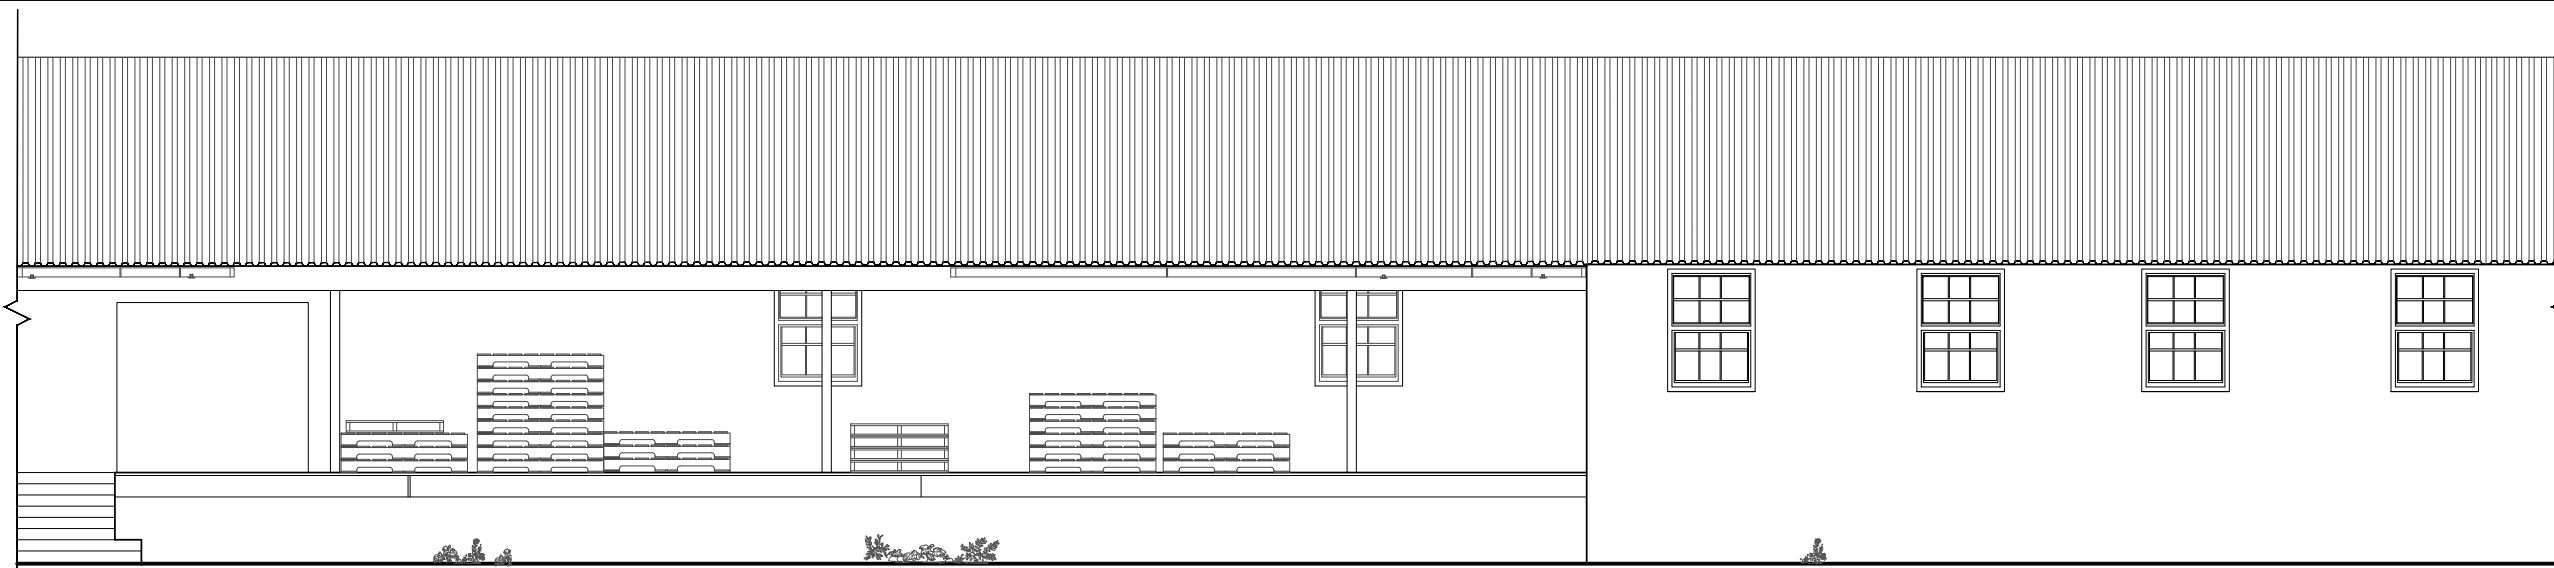

2 EAST ELEVATION CONT.
A.102 / SCALE 1/4" = 1'-0"

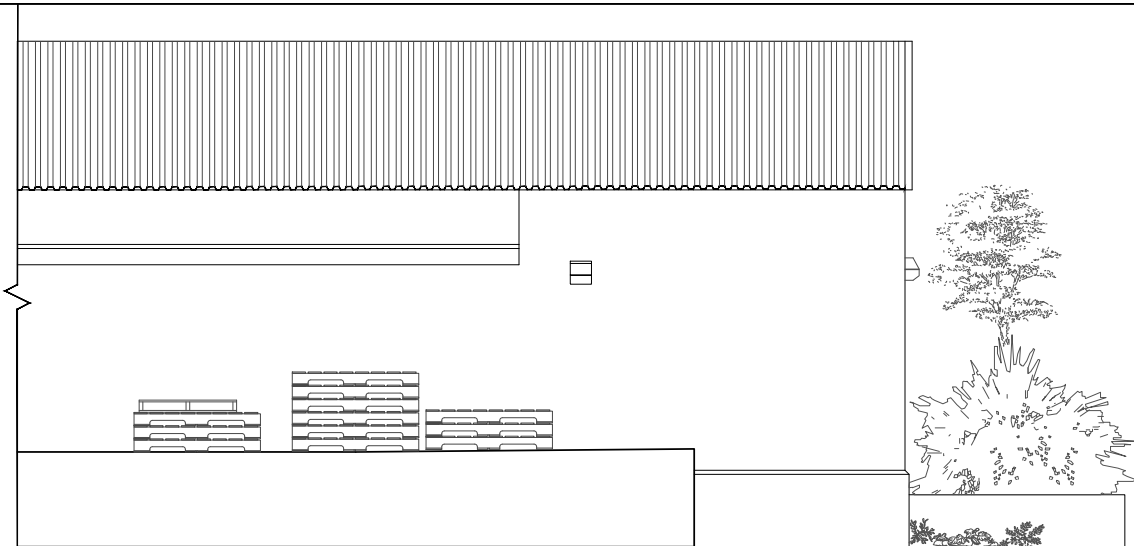

3 EAST ELEVATION CONT.
A.102 / SCALE 3/32" = 1'-0"

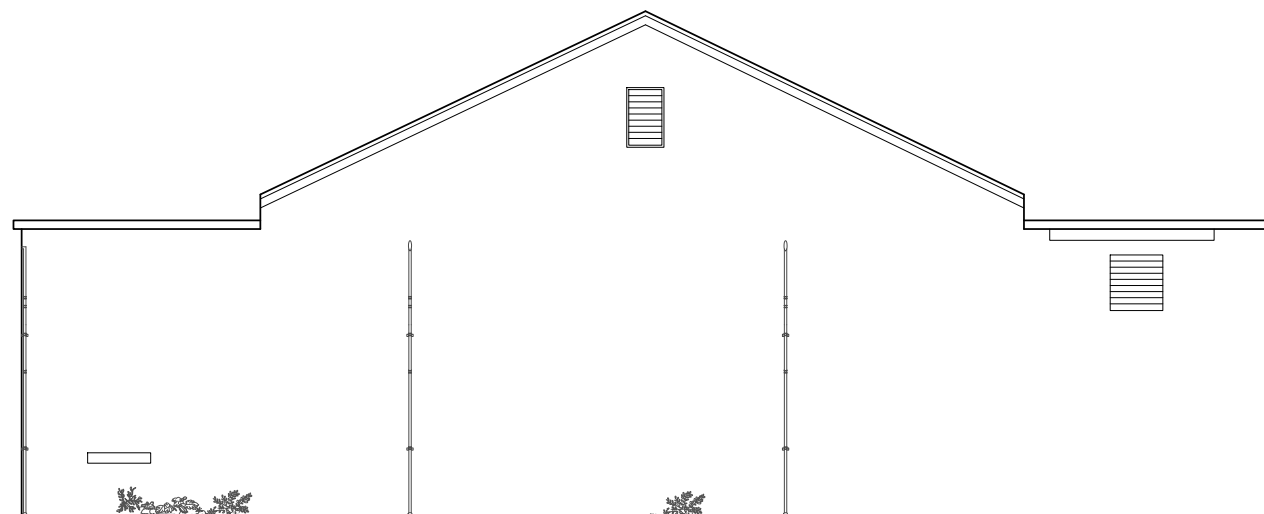

4 SOUTH ELEVATION
A.102 / SCALE 3/32" = 1'-0"

ISSUE / REVISION

No.	Date:

SCALE: AS NOTED

SURVEY

Prepared By: OTHERS Date: -

DESIGN

Prepared By: - Date: -

Checked By: - Date: -

DRAWING

Prepared By: TC Date: FEBRUARY 2020

Checked By: - Date: -

Approved By: -


Project Number: 00.00.00

Project Title: DEVONSHIRE AGRICULTURE SERVICE CENTER

#38 SCHOOLS DRIVE, DEVONSHIRE.

Sheet Title: EXISTING ELEVATIONS

Revisions: Sheet Number:

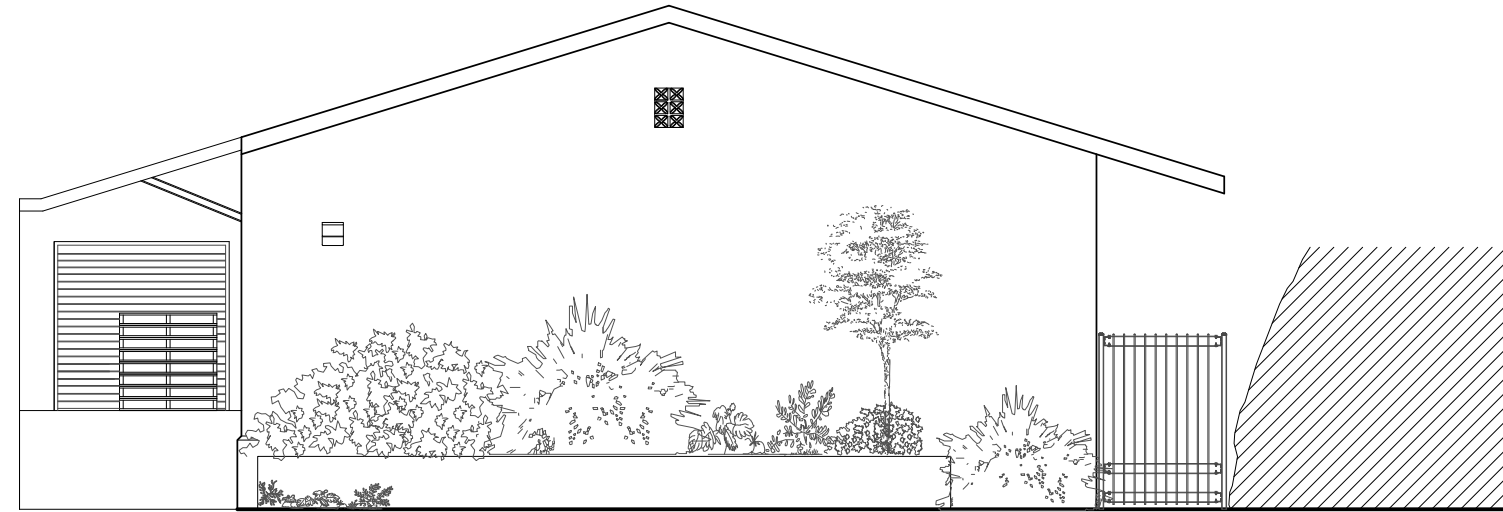

1 NORTH ELEVATION
A.103 SCALE 1/4" = 1'-0"

ISSUE / REVISION	
No.	Date:

SCALE: AS NOTED

SURVEY
Prepared By: OTHERS Date: -

DESIGN
Prepared By: Date: -

Checked By: Date: -

DRAWING
Prepared By: TC Date: FEBRUARY 2020
Checked By: Date: -

Approved By: -


Project Number: 00.00.00

Project Title: DEVONSHIRE AGRICULTURE SERVICE CENTER

#38 SCHOOLS DRIVE, DEVONSHIRE.

Sheet Title: ELEVATION CONT. AND SHORT SECTION


Drawing legend
EXISTING WALL

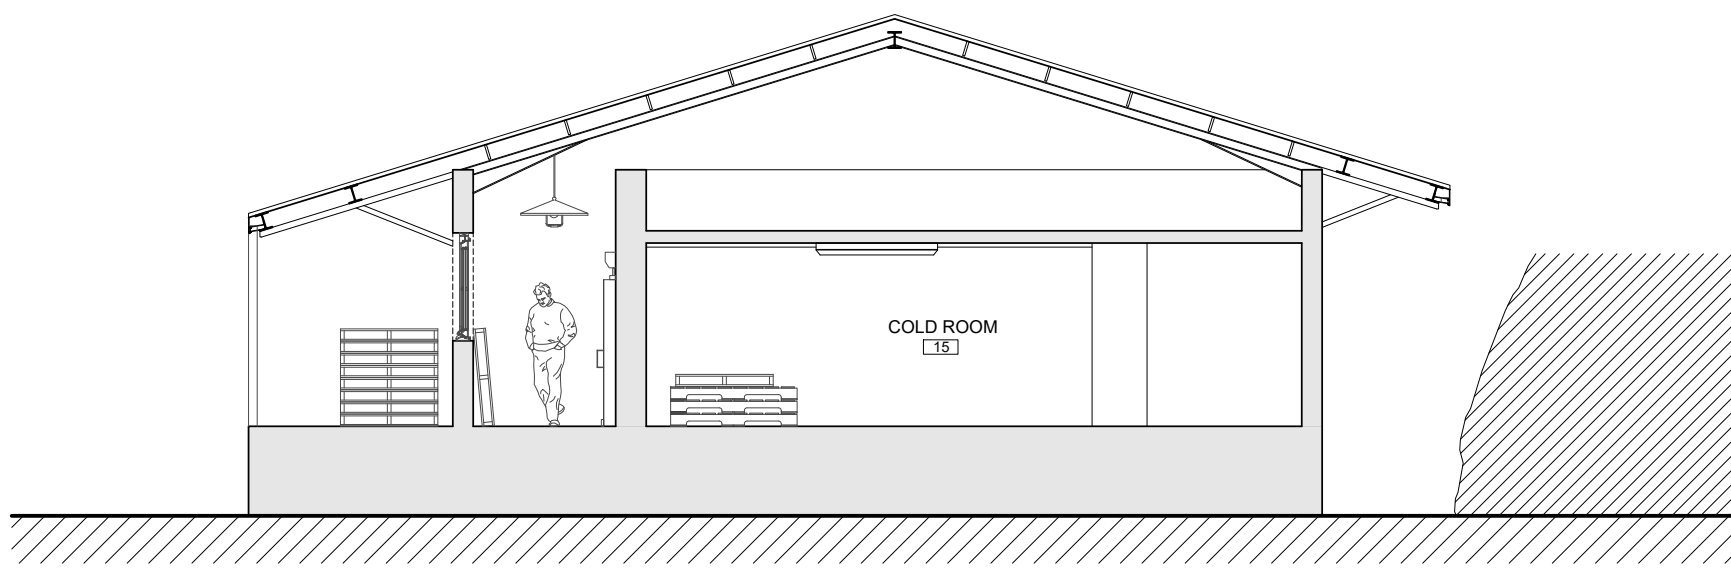

2 SHORT SECTION
A.103 SCALE 1/4" = 1'-0"




FOR CONTINUATION REFER TO DRAWING A.104

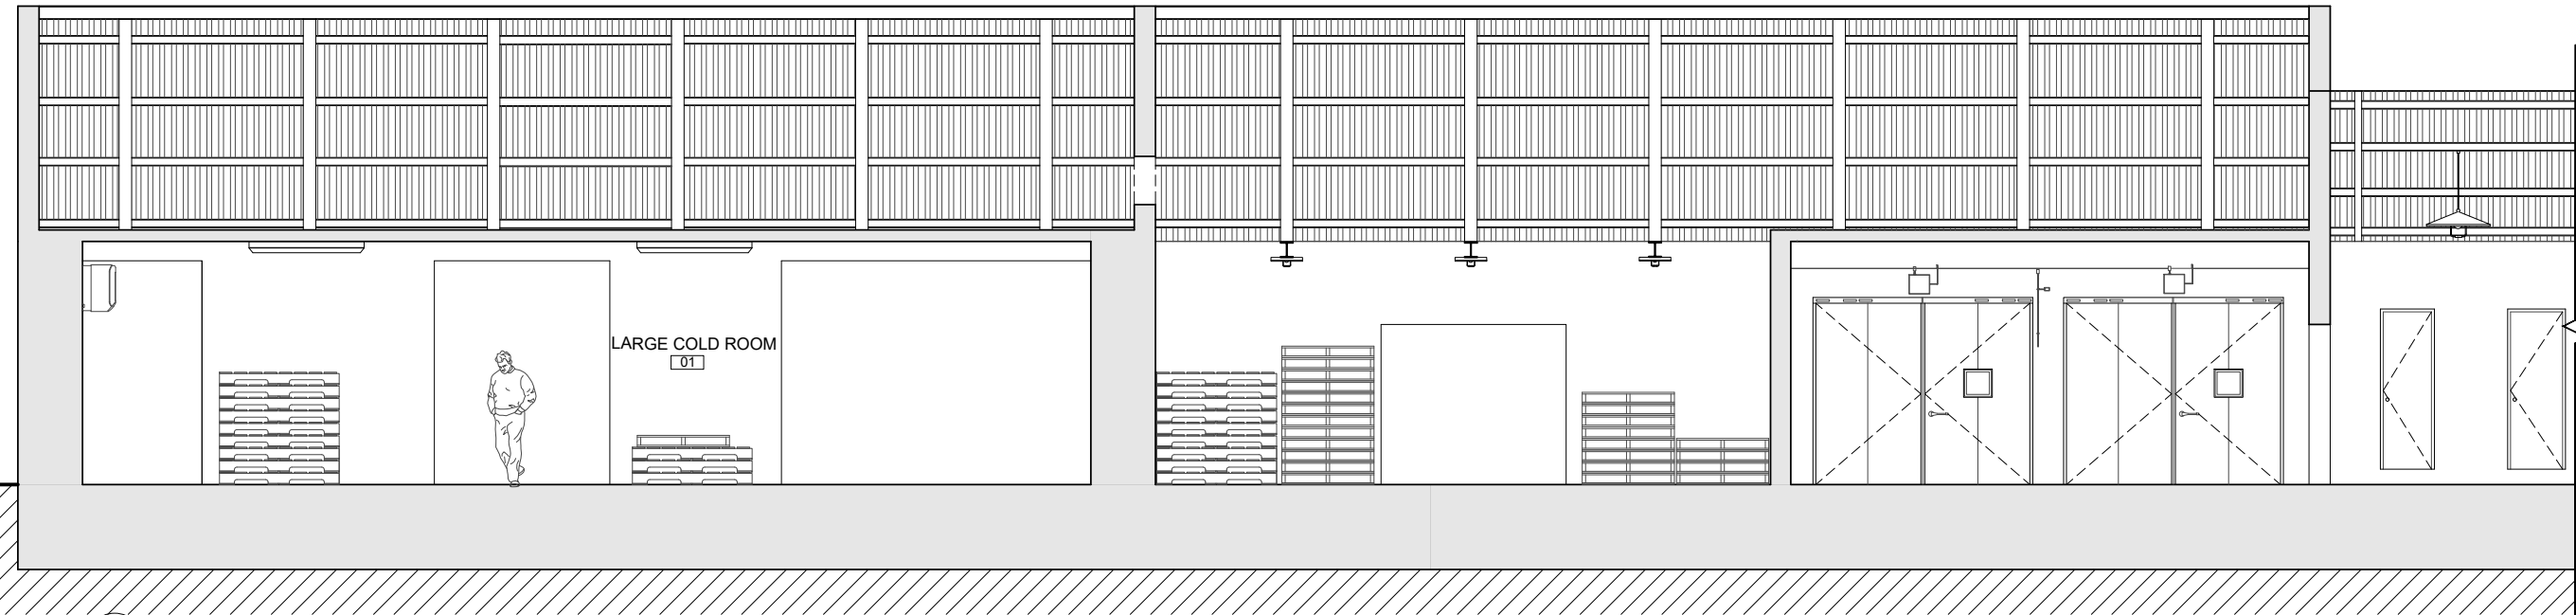

1 LONG SECTION
A.104 SCALE 1/4" = 1'-0"


FOR CONTINUATION REFER TO DRAWING A.104

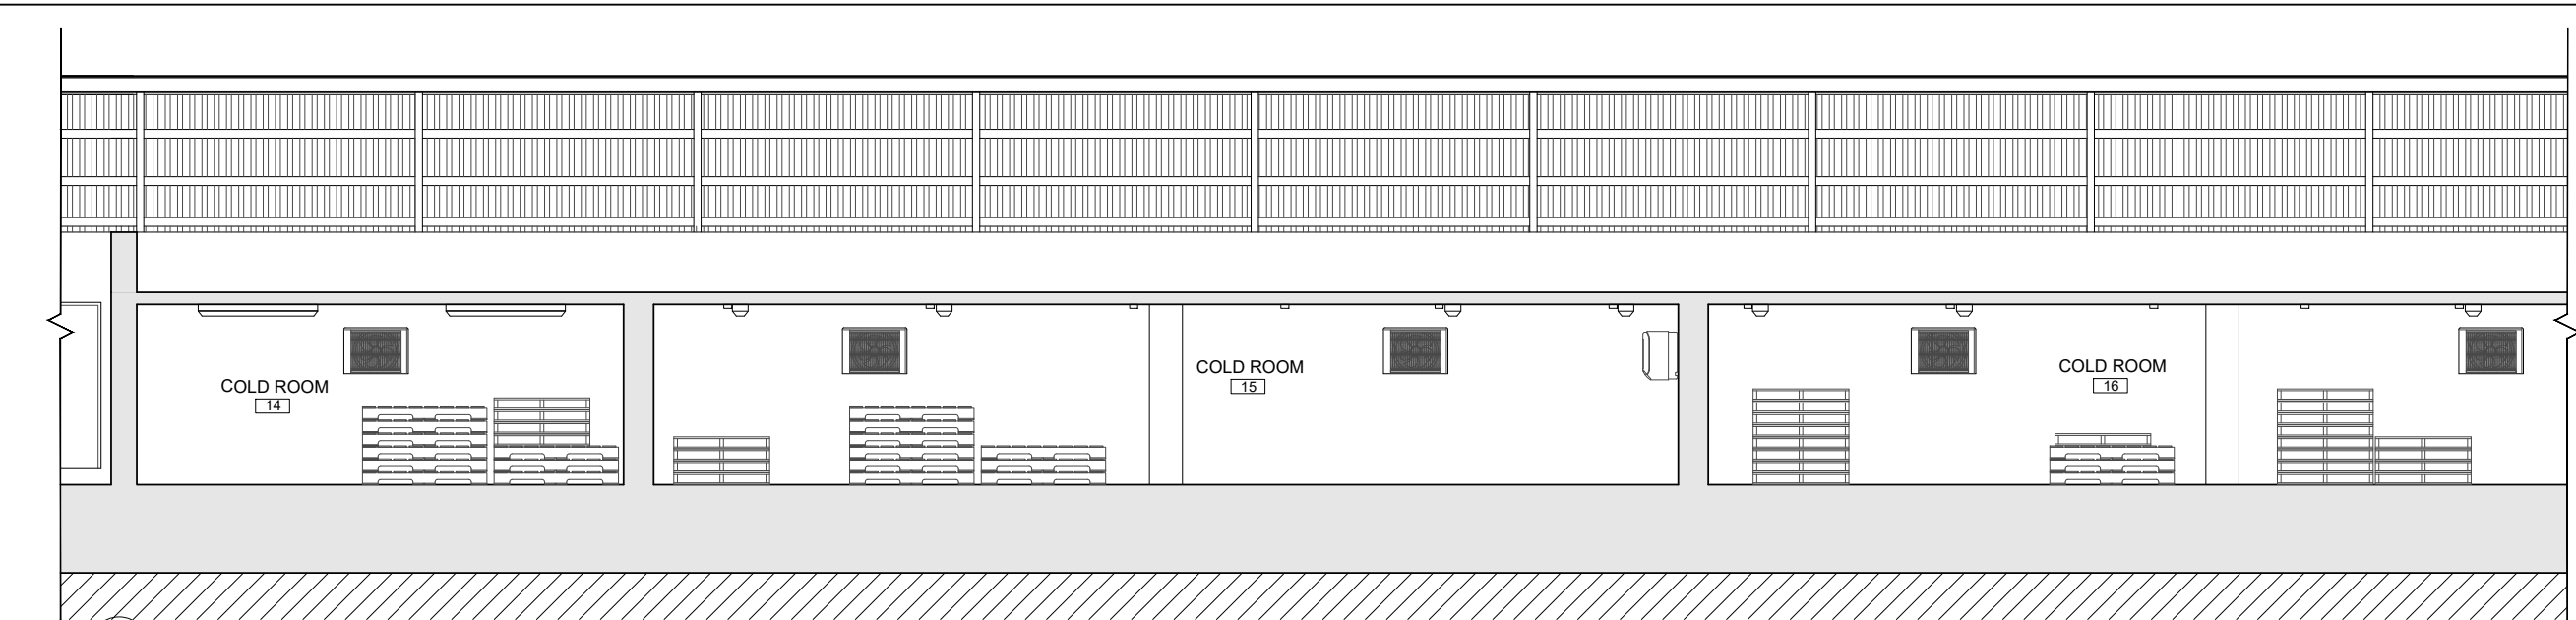

2 LONG SECTION CONT.
A.104 SCALE 1/4" = 1'-0"

Drawing legend

EXISTING WALL

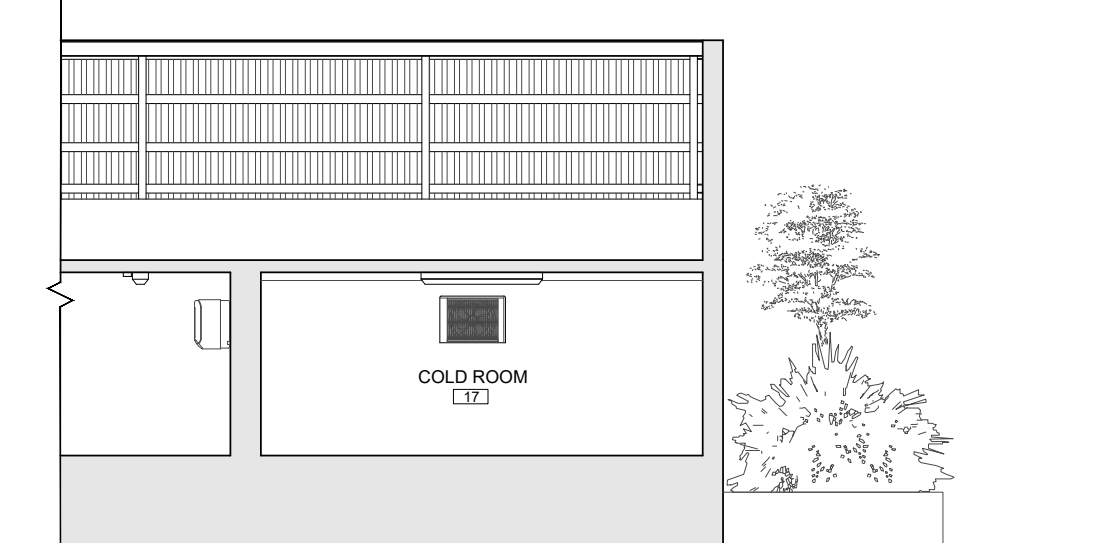

3 LONG SECTION CONT.
A.104 SCALE 3/32" = 1'-0"

ISSUE / REVISION

No.	Date:

SCALE: AS NOTED

SURVEY

Prepared By: OTHERS Date: -

DESIGN

Prepared By: - Date: -

Checked By: - Date: -

DRAWING

Prepared By: TC Date: FEBRUARY 2020

Checked By: - Date: -

Approved By: -

Project Number: 00.00.00

Project Title: DEVONSHIRE AGRICULTURE SERVICE CENTER

#38 SCHOOLS DRIVE, DEVONSHIRE.

Sheet Title: EXISTING GROUND FLOOR PLAN

Revisions: Sheet Number: A.104